



Existing Building Field Verification/ Measurements

www.franzarchitects.com

O: 817 737-9922

E: info@franzarchitects.com

4055 International Plaza, Suite 100, Fort Worth, TX



1 AS-BUILT FLOOR PLAN
SCALE: 1/4" = 1'-0"

PROJECT # _____
BURGER KING RESTAURANT

SEAL



DRAWN BY:		CHECKED BY:		DATE:
NO.	DATE	REVISION		




1 AS-BUILT CEILING PLAN
SCALE: 1/4" = 1'-0"

PROJECT #
BURGER KING RESTAURANT


SEAL




DRAWN BY:		CHECKED BY:		DATE:
NO.	DATE	REVISION		

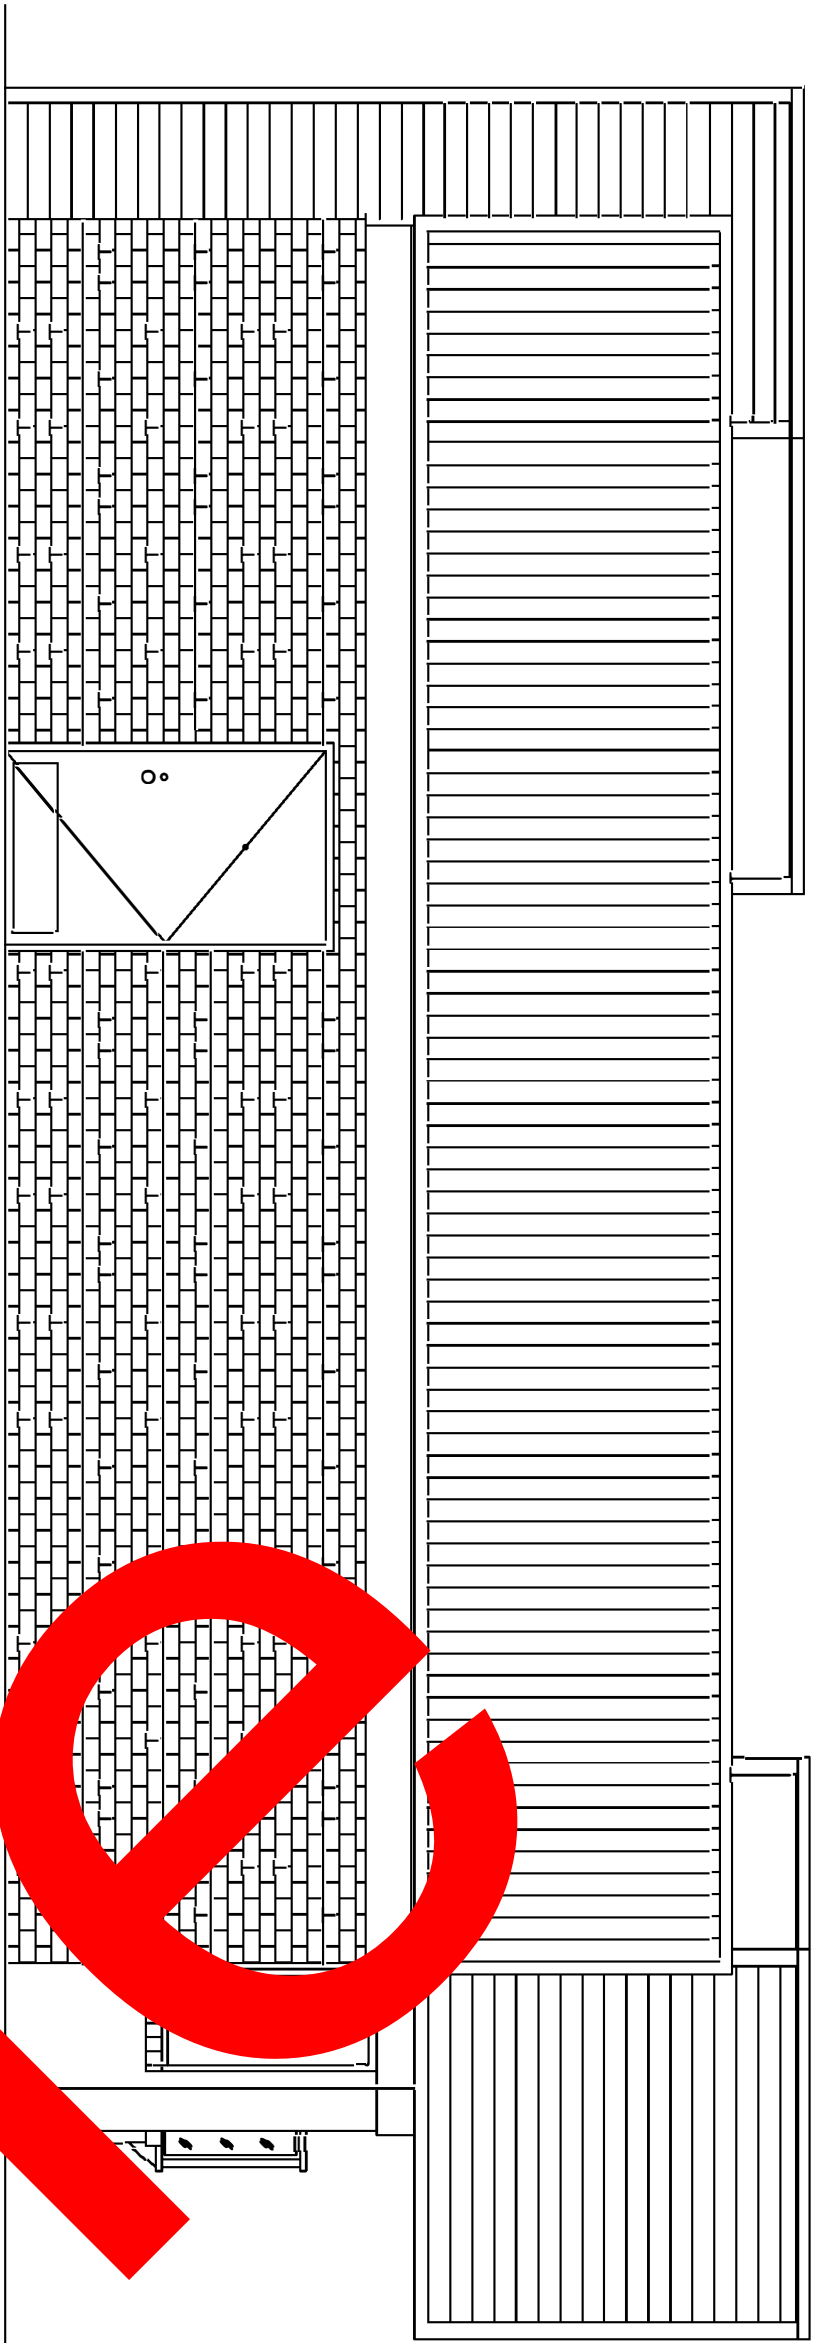


1 EXISTING NORTH ELEVATION
SCALE: 1/4" = 1'-0"

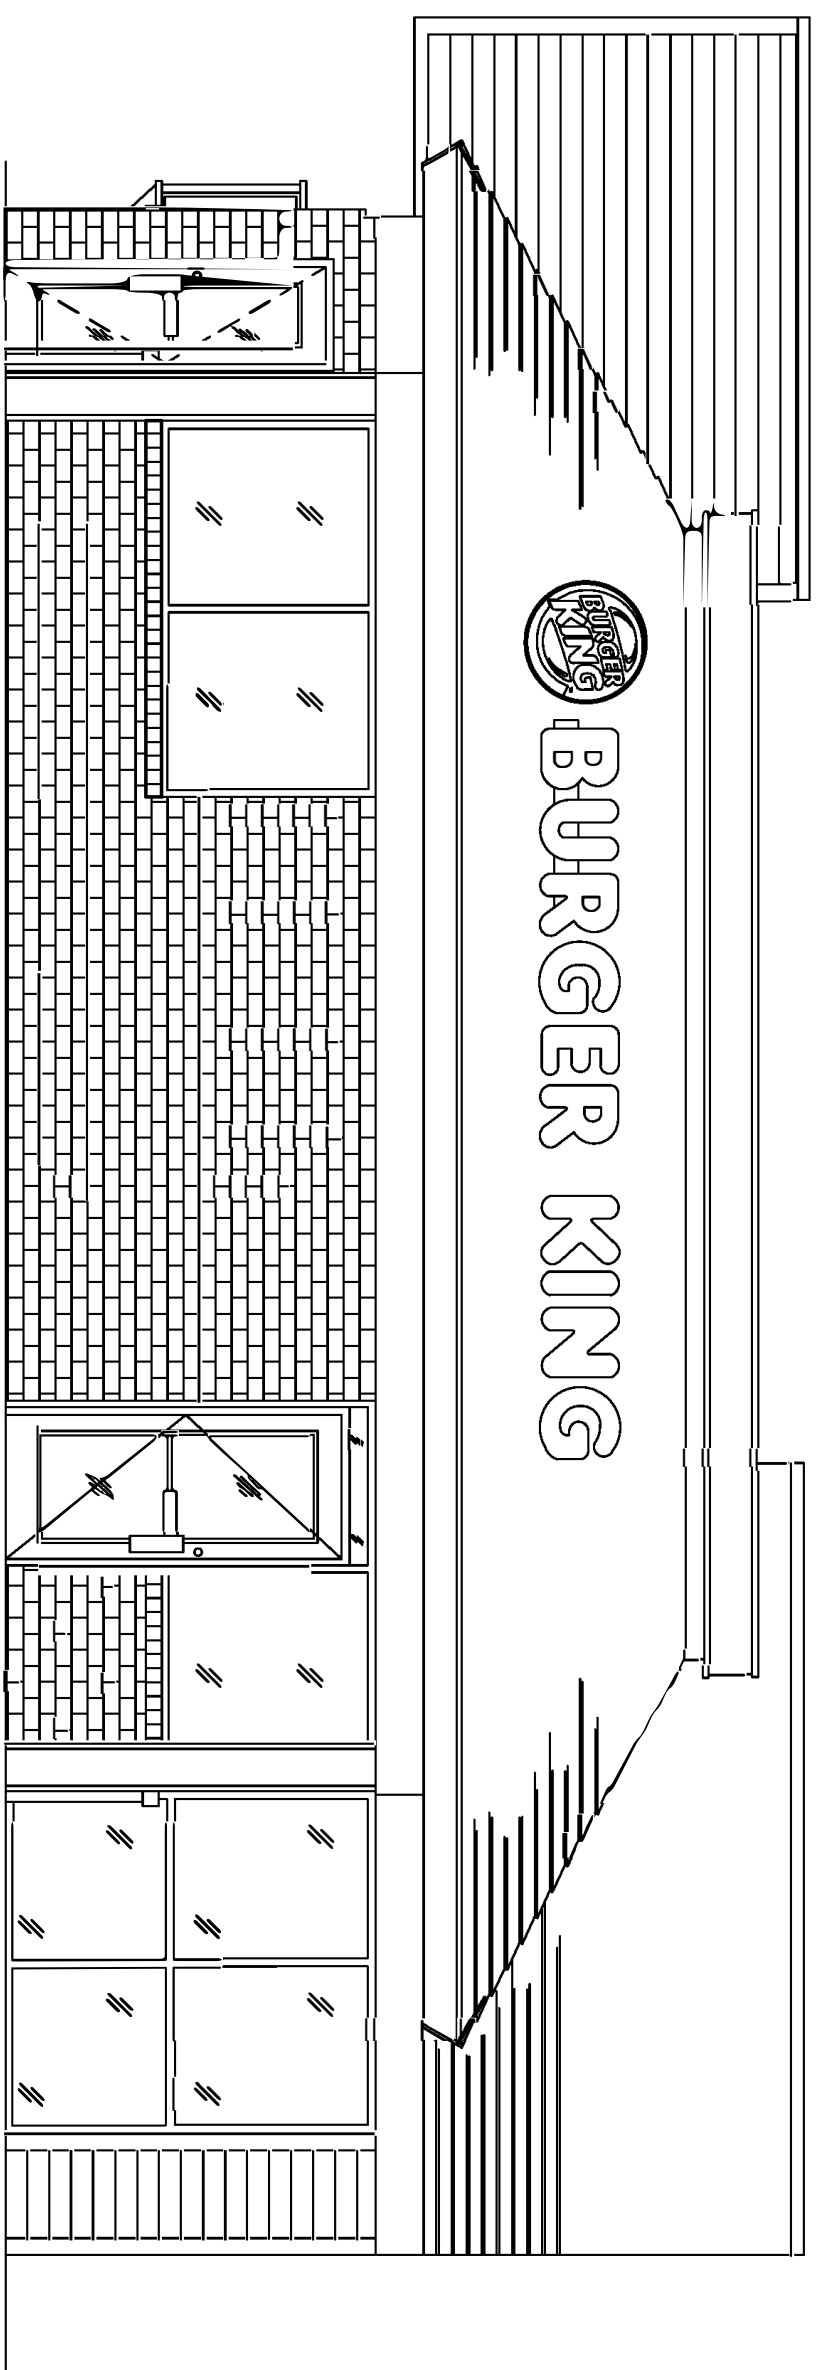

2 EXISTING SOUTH ELEVATION
SCALE: 1/4" = 1'-0"

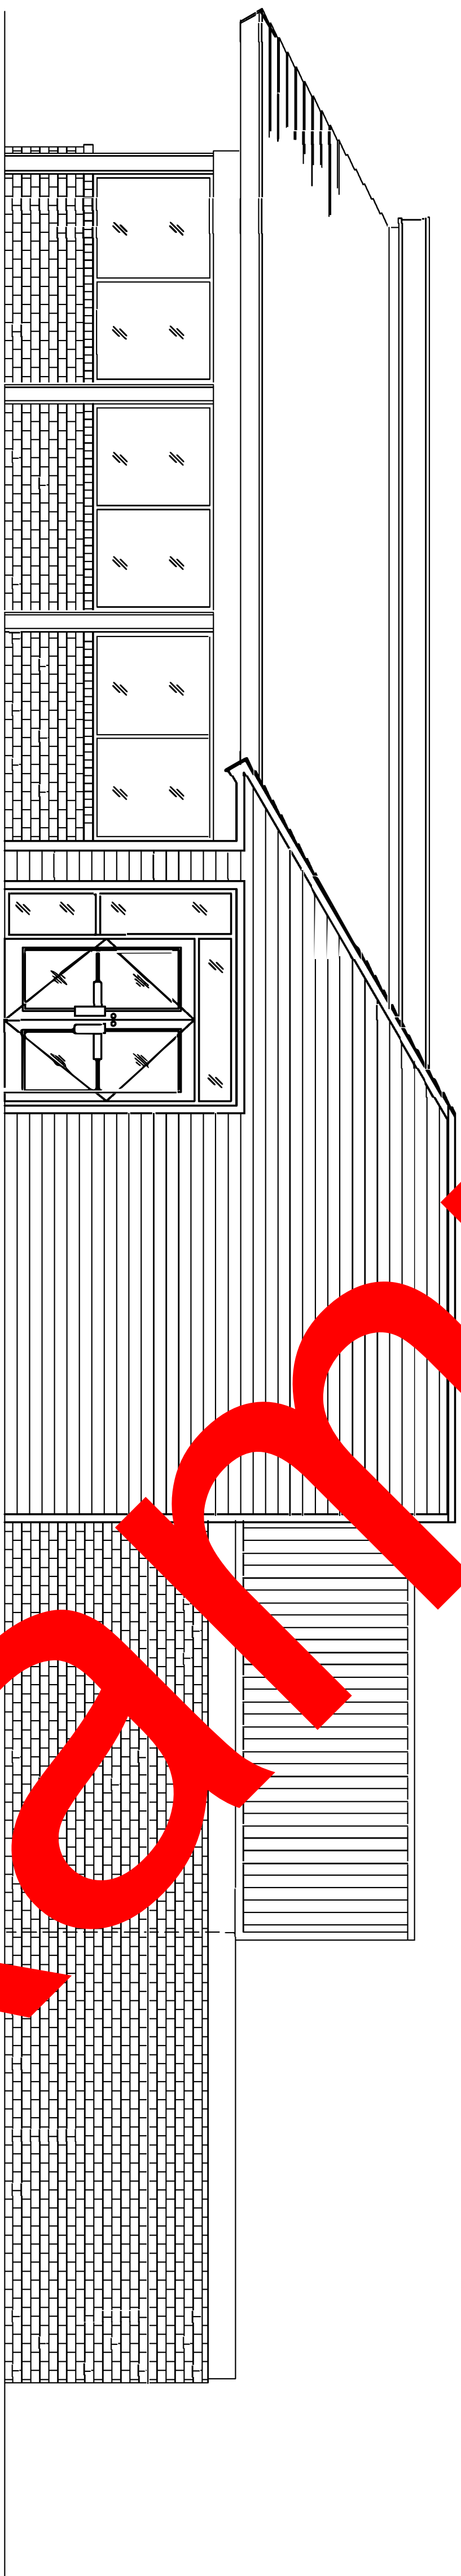

3 EXISTING EAST ELEVATION
SCALE: 1/4" = 1'-0"

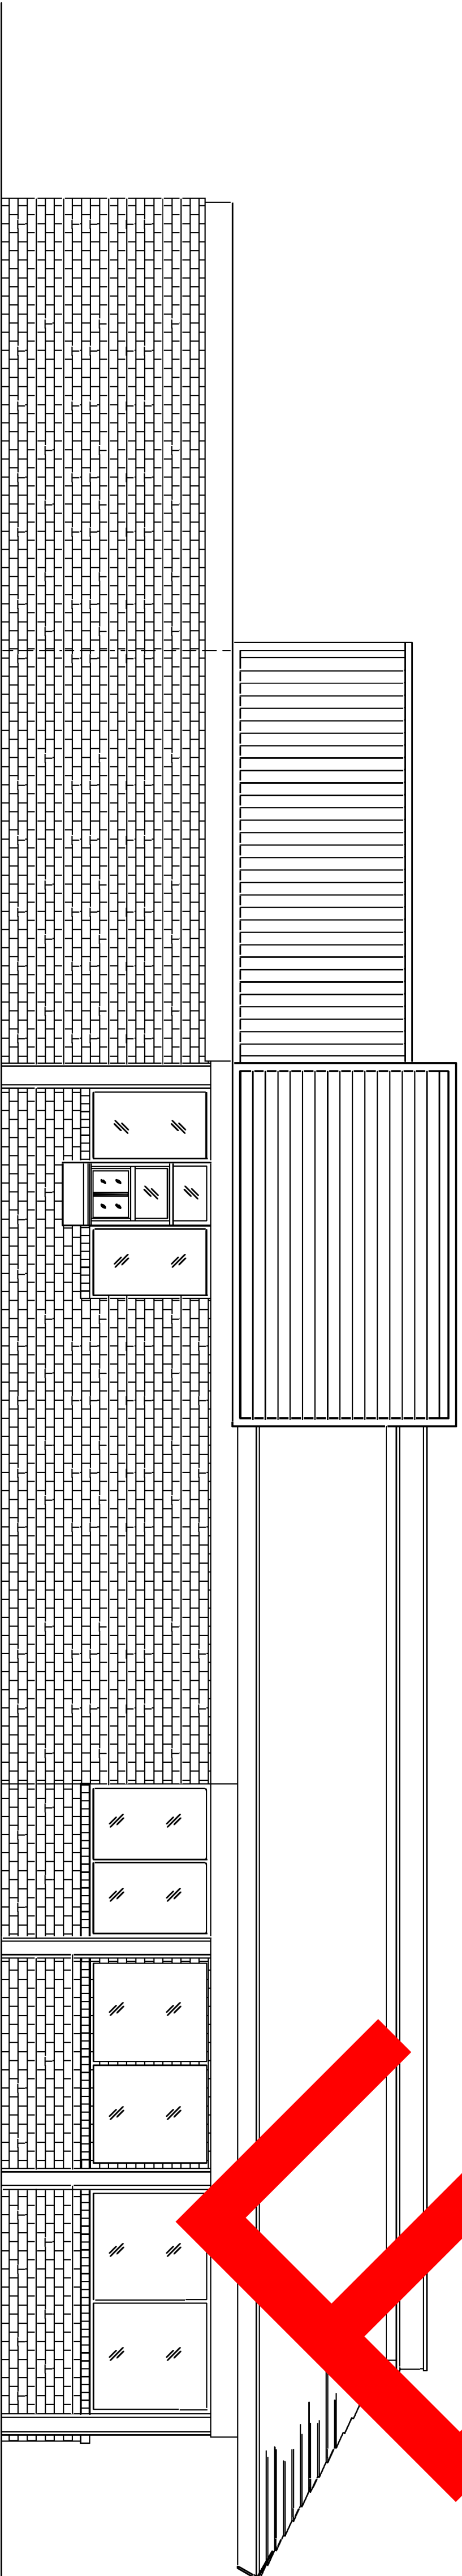

4 EXISTING WEST ELEVATION
SCALE: 1/4" = 1'-0"

Example

PROJECT #:	SEAL
BURGER KING RESTAURANT	



DRAWN BY:	CHECKED BY:	DATE:
NO.	DATE	REVISION